



*Tradition Design Review Committee
Architectural Review*

10807 SW Tradition Square Port St. Lucie, FL 34987

Phone (772) 345-5101

Date: 3.5.24

To: Retail DG

Attention: Tod Mowrey

100 s. 2nd Street

Ft. Pierce, FL 34950

Regarding: Paradise Car Wash Site Plan Amendment – Addition of Cell Tower

This notice serves as the Design Review Committee's response to your request as referenced above. Please note any comments made by the Committee as listed below.

If you have any questions regarding this matter, please do not hesitate to contact the Committee at (772) 345-5101.

Status: Approved With Comments

The Committee has reviewed this application and has approved it with the following comments:

Landscape:

- Proposed Crape Myrtle shall be replaced with evergreen species, suggest Japanese Tree Fern, Japanese Blueberry or Holly at same specifications.*

Site Plan:

- Future Verizon wireless 10' long equipment rack is placed over existing storm pipe. Prefer not to have actual equipment over the pipe.*

Design:

- Is there an alternative to the monopole proposed? Design Review Committee would like to review if so, and reserve the right to choose a different design.*

Thank you.

Tradition Design Review Committee

TRADITION DESIGN REVIEW COMMITTEE

☒
☐
☒

APPROVED:


REMOVED:

COMMENTS:

DATE: MAR 05 2024

Signature

PROJECT NUMBER:

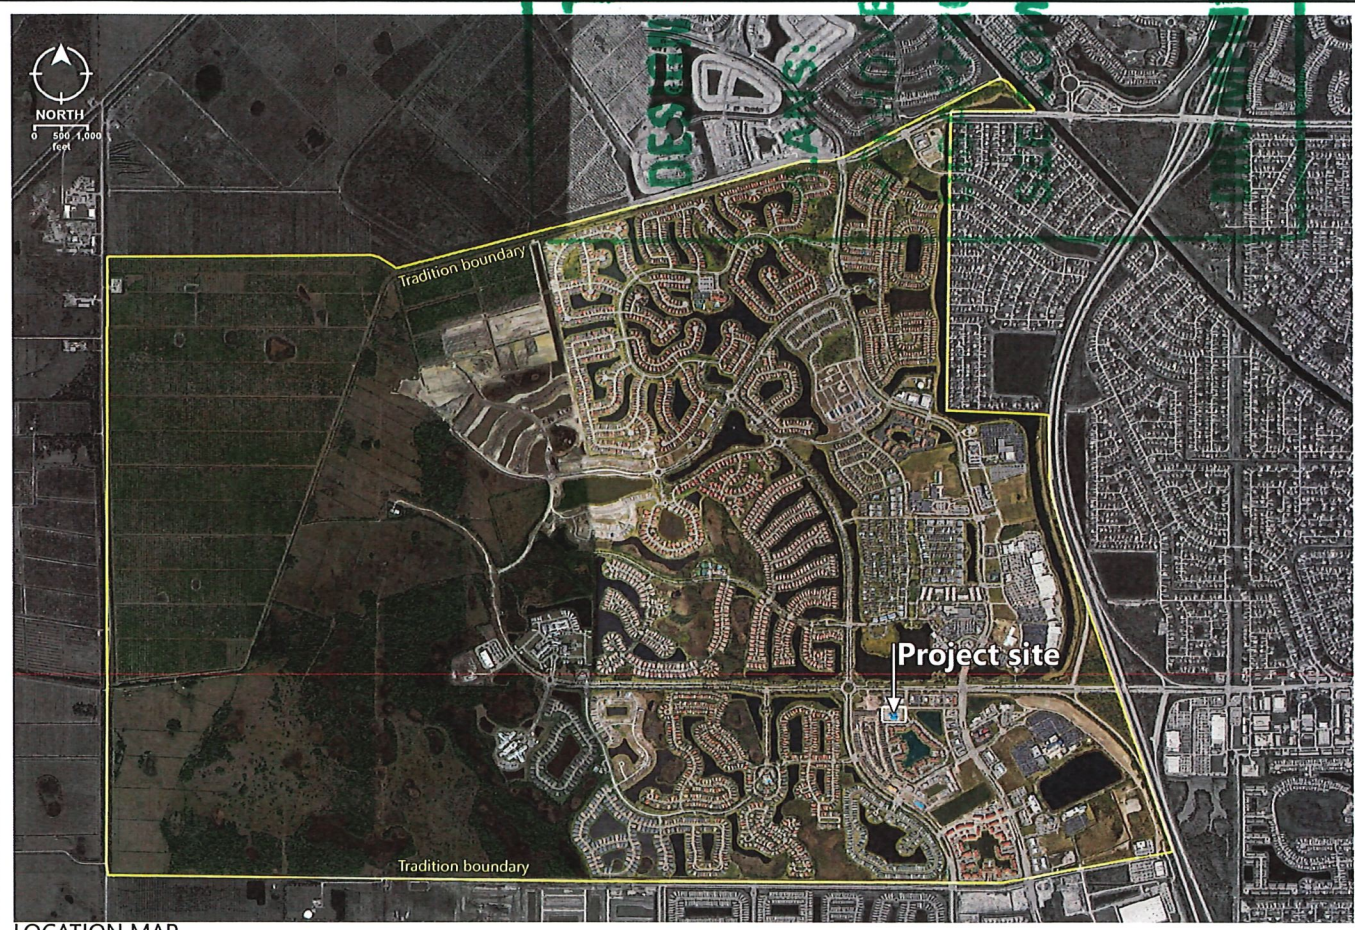

LOCATION MAP

100 S. 2nd Street
Fort Pierce, FL 34950

TM
Designed by
VP
Drawn by


PARADISE CAR WASH - CELL TOWER
MINOR SITE PLAN AMENDMENT
TRADITION PORT ST. LUCIE

DTI
DYNAMIC TOWERS, INC.
2024 RELEASE UNDER A
FOUO (U.S. CASE NO. 2024-
072) 375-8818

GEN
ENGINEERING
1718 RD. 1000
WEST PALM BEACH, FL 33411
(561) 835-1234

01/19/2024

SHEET 01 of 06

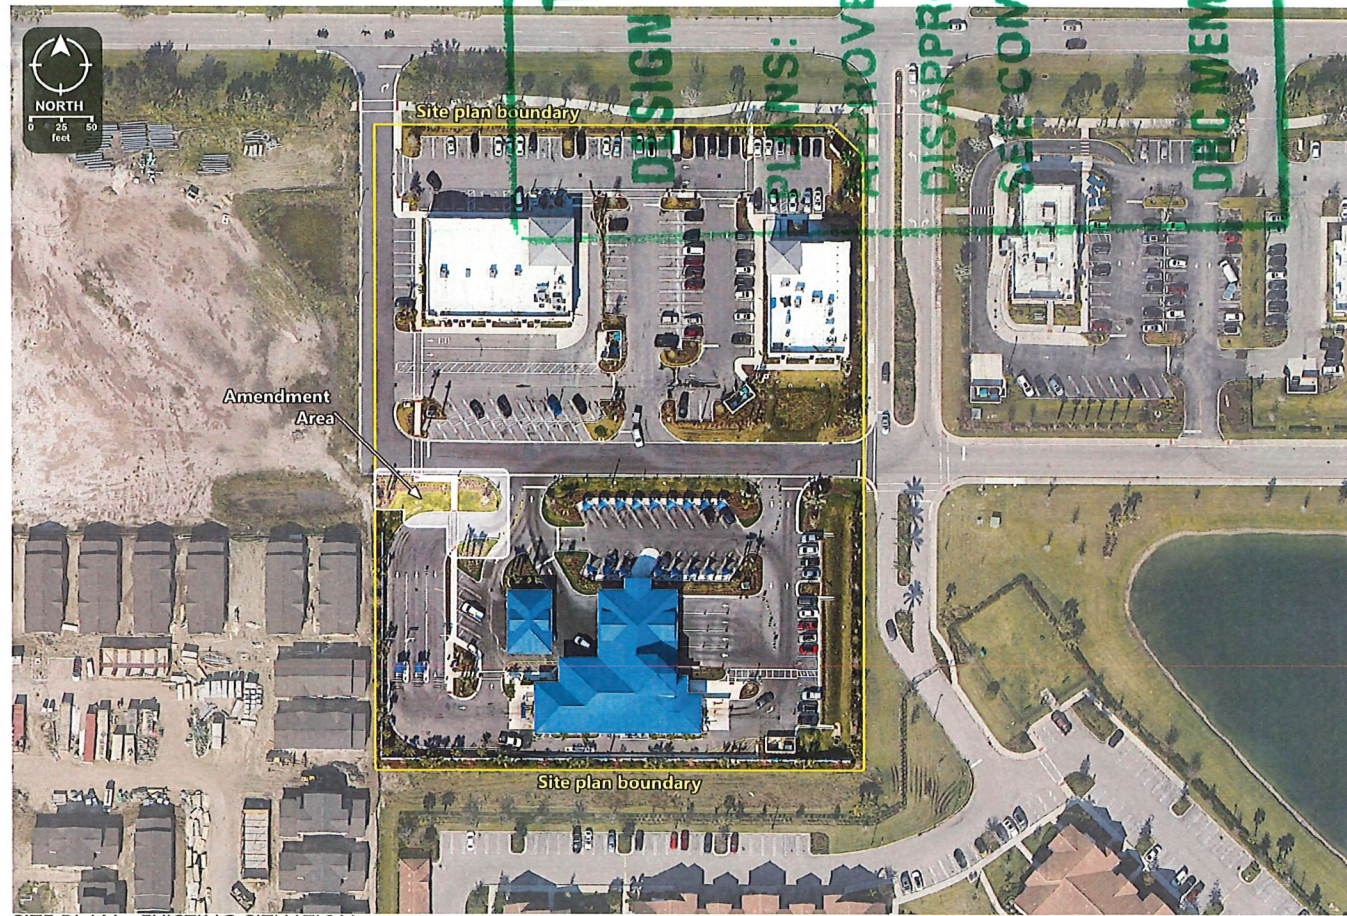

SITE PLAN - EXISTING SITUATION

TRADITION DESIGN REVIEW COMMITTEE

☒
☐
☒

APPROVED:

DISAPPROVED:

SEE COMMENTS:

MAR 05 2024

DATE:

DEC MEMBER:

Angela



TM
Designed by
VP
Drawn by

PARADISE CAR WASH - CELL TOWER
MINOR SITE PLAN AMENDMENT
TRADITION PORT ST. LUCIE



01/19/2024

SHEET 02 of 06



SITE PLAN - PROPOSED TOWER



TRADITION
DESIGN REVIEW COMMITTEE



APPROVED:

DISAPPROVED:

SEE COMMENTS:

DATE: MAR 05 2024

DATE:

Aradun

IPC MEMBER




TM
Designed by
VP
Drawn by

PARADISE CAR WASH - CELL TOWER
MINOR SITE PLAN AMENDMENT
TRADITION PORT ST. LUCIE



01/19/2024

SHEET 03 of 06

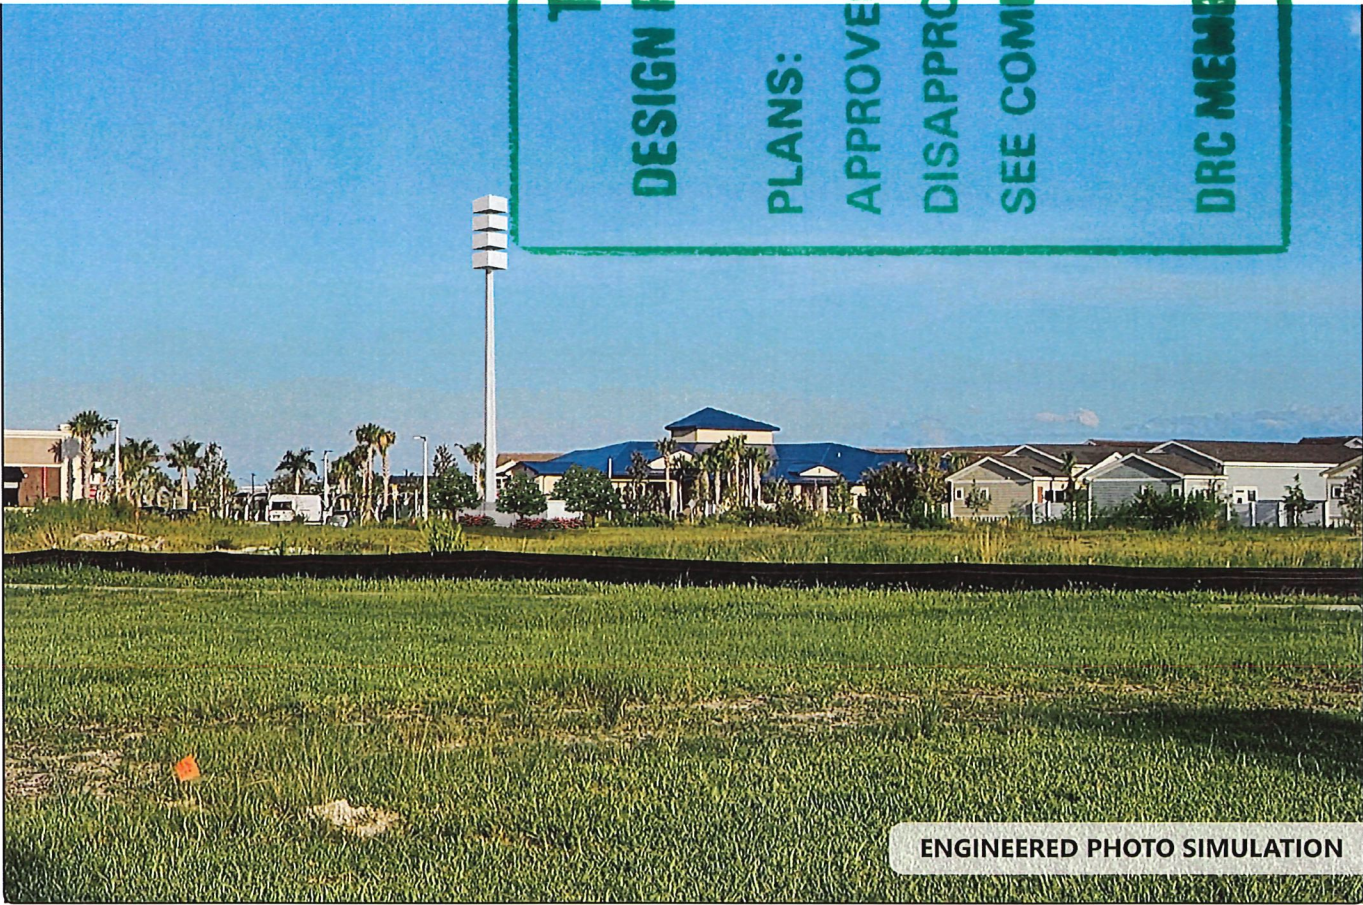

ENGINEERED PHOTO SIMULATION

TRADITION DESIGN REVIEW COMMITTEE

PLANS:

APPROVED:



DISAPPROVED:



SEE COMMENTS:



DATE:

MAR 05 2024

DRC MEMBER

[Signature]



TM
Designed by
VP
Drawn by

PARADISE CAR WASH - CELL TOWER
MINOR SITE PLAN AMENDMENT
TRADITION PORT ST. LUCIE



01/19/2024

SHEET 04 of 06



ENGINEERED PHOTO SIMULATION

TRADITION DESIGN REVIEW COMMITTEE

PLANS:



APPROVED:



DISAPPROVED:



SEE COMMENTS:

MAR 05 2024

DATE:

DRC MEMBER:

Handwritten signature



TM
Designed by
VP
Drawn by

PARADISE CAR WASH - CELL TOWER
MINOR SITE PLAN AMENDMENT
TRADITION PORT ST. LUCIE



01/19/2024

SHEET 05 of 06



ENGINEERED PHOTO SIMULATION

TRADITION DESIGN REVIEW COMMITTEE

PLANS:



APPROVED:



DISAPPROVED:



SEE COMMENTS:

DATE: MAR 05 2024

DRC MEMBER:

Signature



TM
Designed by
VP
Drawn by

PARADISE CAR WASH - CELL TOWER
MINOR SITE PLAN AMENDMENT
TRADITION PORT ST. LUCIE



01/19/2024

SHEET 06 of 06

