

RECEIVED

AUG 02 2019


PLANNING DEPARTMENT
CITY OF PORT ST. LUCIE, FL




01 WEST ELEVATION
HOTEL
SCALE 1/8" = 1'-0"

MATERIAL LEGEND	
1	SMOOTH STUCCO FINISH W/ REVEALS
2	TEXTURED STUCCO FINISH W/ REVEALS
3	IMPACT RATED ALUMINUM WINDOWS W/ SILVER FRAME
4	IMPACT RATED HOLLOW METAL DOOR
5	IMPACT RATED ALUMINUM STOREFRONT SYSTEM W/ SILVER FRAME
6	SIGNAGE PER HILTON DESIGN STANDARDS
7	ALUMINUM PTAC LOUVER
8	ALUMINUM COPING-COLOR TO MATCH ADJACENT MATERIAL
9	STUCCO CONTROL JOINT
10	OVERFLOW SCUPPER
11	ALUMINUM CANOPY
12	12" HIGH ADDRESS NUMBERS


COLOR LEGEND	
[Blue Swatch]	PANTONE PMS PROCESS CYAN
[Dark Blue Swatch]	PANTONE PMS TC BLACK
[White Swatch]	FINISH TO MATCH DRYVIT OVERCAST 813B OR EQUAL
[Light Gray Swatch]	FINISH TO MATCH DRYVIT GLACIER 207 OR EQUAL
[Brown Swatch]	FINISH TO MATCH DRYVIT TATTLTALE 815A OR EQUAL
[Light Blue Swatch]	PANTONE PMS 317C
[Dark Blue Swatch]	PANTONE PMS 2955C
[Dark Blue Swatch]	PANTONE PMS 2685C
[Orange Swatch]	SW 6635 - DETERMINED ORANGE
[Dark Blue Swatch]	BM 1595 - NIGHTFALL / HIGH GLOSS 148

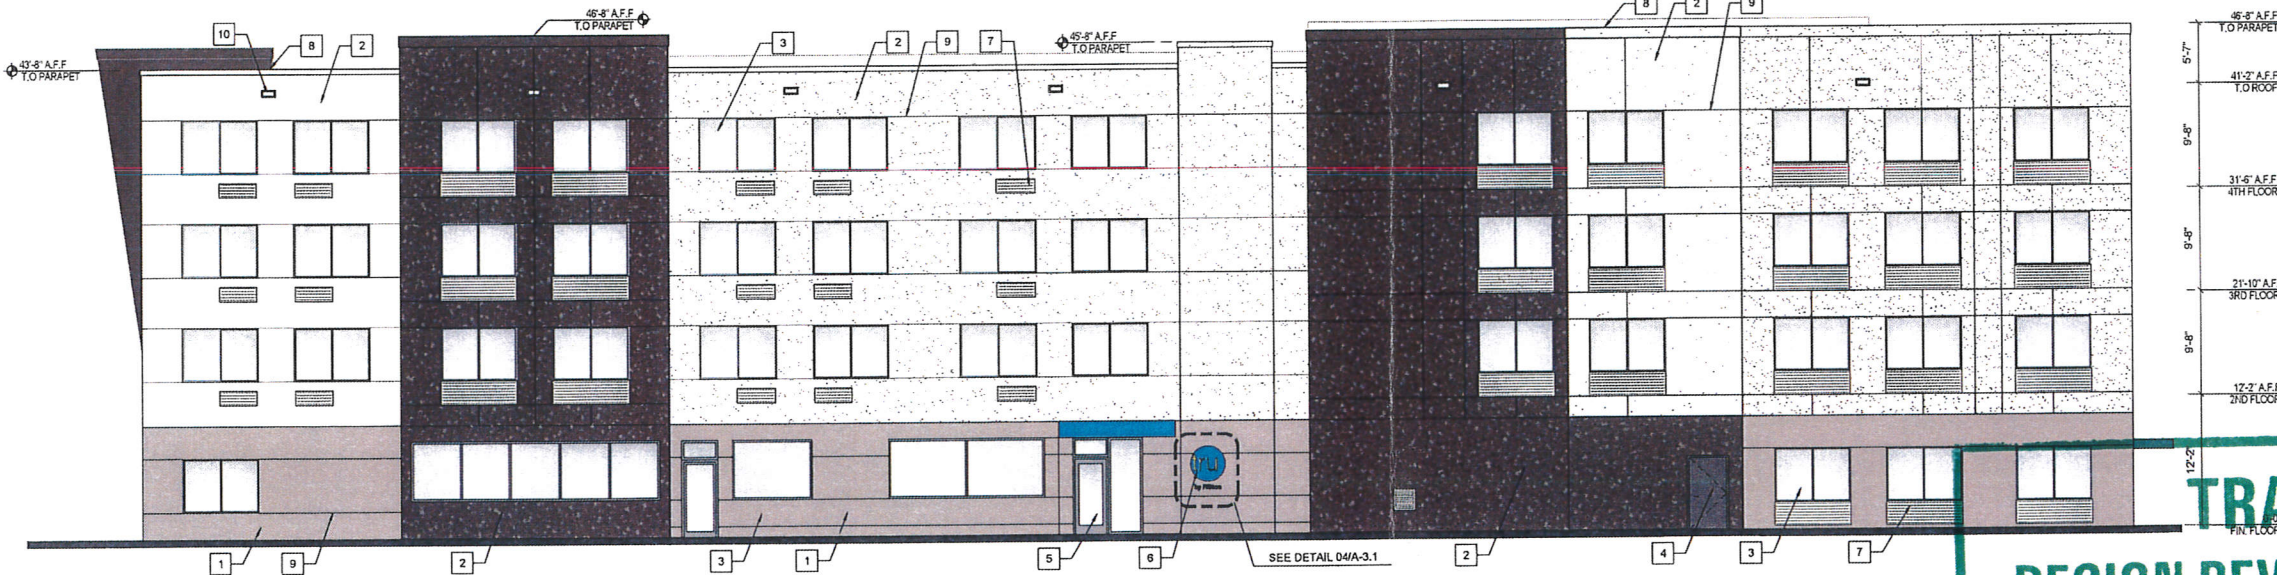

02 EAST ELEVATION
HOTEL
SCALE 1/8" = 1'-0"

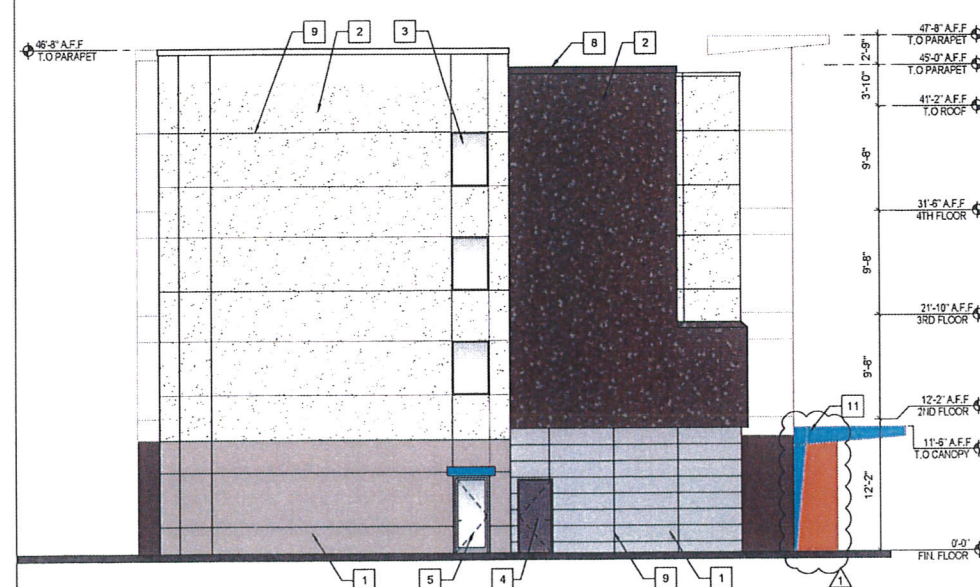

04 NORTH ELEVATION
HOTEL
SCALE 1/8" = 1'-0"

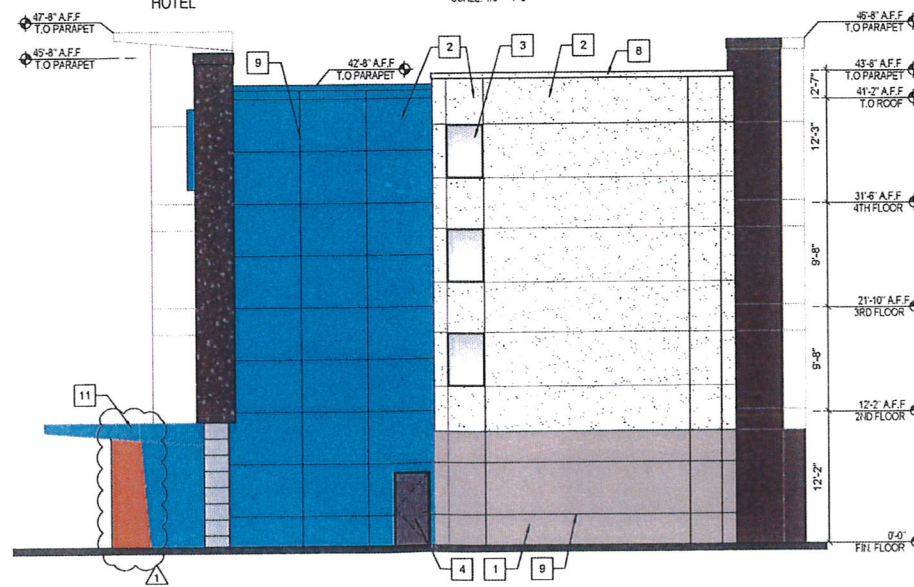

03 SOUTH ELEVATION
HOTEL
SCALE 1/8" = 1'-0"

TRADITION
DESIGN REVIEW COMMITTEE

PLANS:

APPROVED:

DISAPPROVED:


SEE COMMENTS:

DATE: AUG 02 2019

DRG MEMBER

KEY PLAN

SCALE NTS

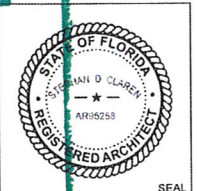

PROJECT #	19-013
DATE	6-3-2019
REV #	DATE
△	DRC COMMENTS
△	7-12-19
△	
△	
SHEET #	
A-2.1	
COPYRIGHT	2018

Claren Architecture + Design, Inc.


AA26002865
6400 CONGRESS AVE. SUITE 2150
BOCA RATON, FL 33487
561.961.4884

Discovery Plaza & Hotel
Village Parkway Dr. & SW Discovery Way
Port St. Lucie, FL 34987




RECEIVED

AUG 2 2019

PLANNING DEPARTMENT
CITY OF PORT ST. LUCIE, FL

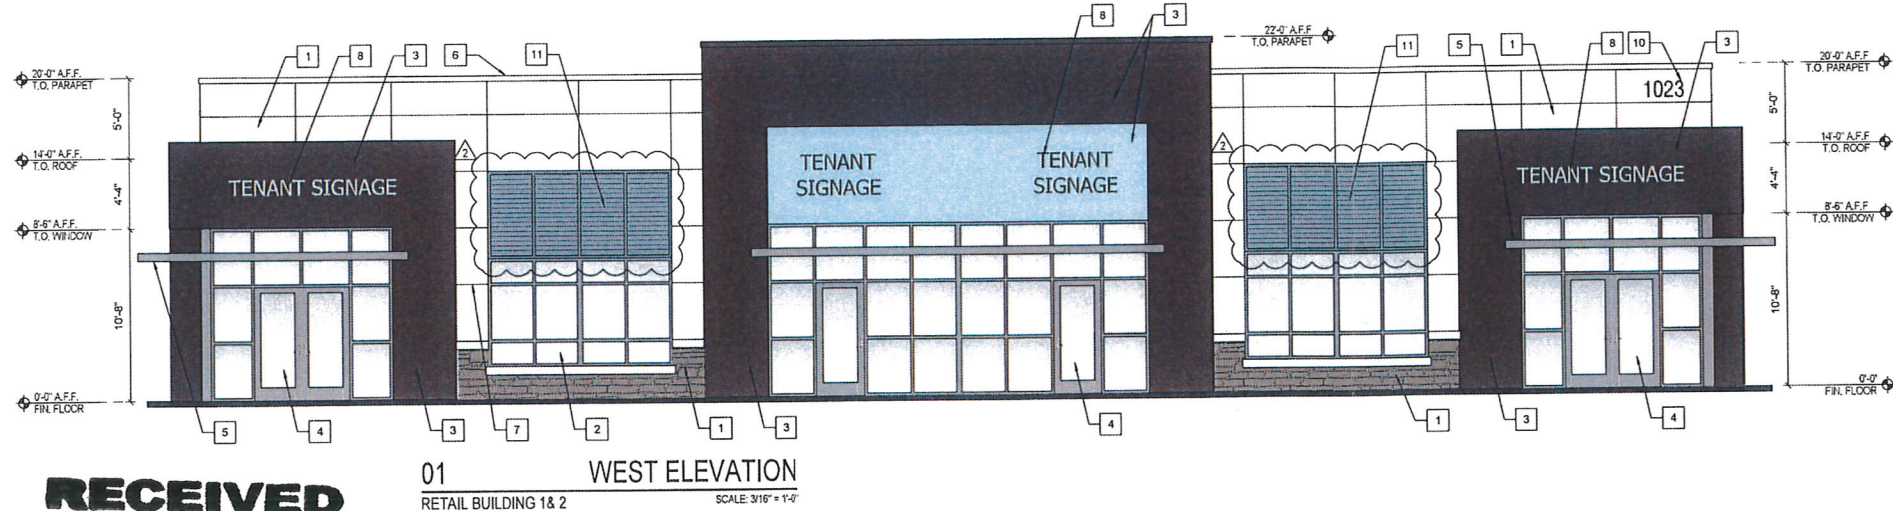

MATERIAL LEGEND	COLOR LEGEND
1 STONE FINISH	SW 6492 - JETSTREAM
2 IMPACT RATED ALUMINUM WINDOWS W/ SILVER FRAME	PAINTONE TC BLACK
3 SMOOTH STUCCO FINISH	SW 7003 - TOQUE WHITE
4 IMPACT RATED ALUMINUM STOREFRONT SYSTEM W/ SILVER FRAME	BM 1465 - NIBERUS
5 ALUMINUM CANOPY	BAHAMA SHUTTER RAL 7001 - SILVER GREY
6 ALUMINUM COPING	BLUFFSTONE MINERET EL DORADO STONE
7 STUCCO CONTROL 'V' JOINT	SAIL SHADE SUIABRELLA FIBRESIST FOG R3024-0000 FABRIC
8 FUTURE SIGNAGE UNDER SEPARATE PERMIT TO COMPLY W/ TRADITION MASTER SIGN PROGRAM	
9 FUTURE SIGNAGE UNDER SEPARATE PERMIT TO COMPLY W/ TRADITION MASTER SIGN PROGRAM	
10 8" HIGH ADDRESS NUMBERS	
11 FIXED ALUMINUM BAHAMA SHUTTER	

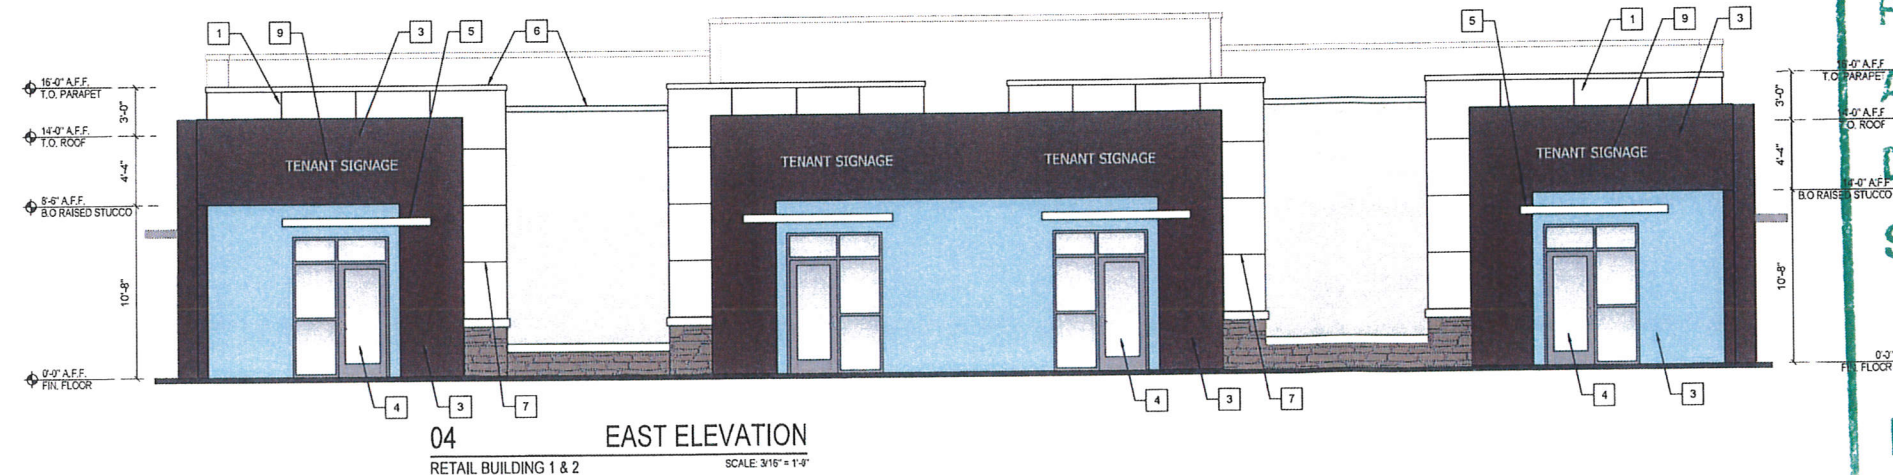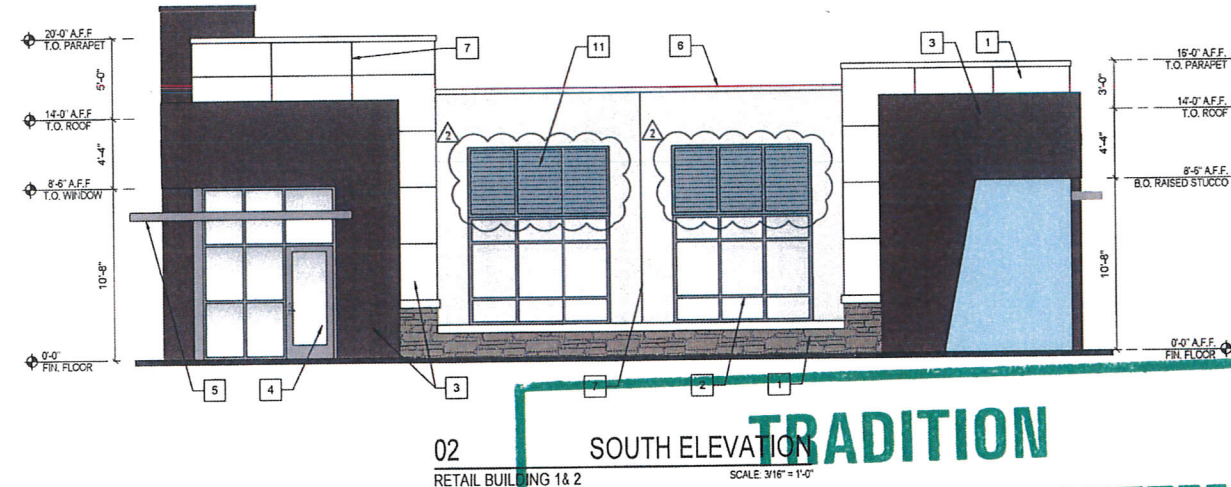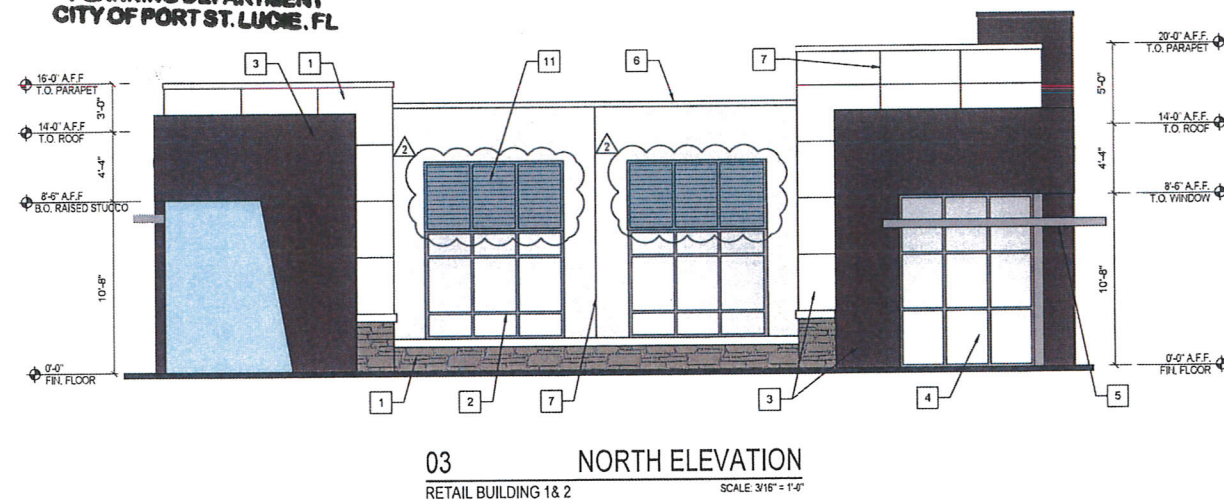

TRADITION DESIGN REVIEW COMMITTEE

PLANS:

APPROVED:

DISAPPROVED:


SEE COMMENTS:

DATE:

DRC MEMBER:

HOTEL	☒
RETAIL BUILDING 1	☐
RETAIL BUILDING 2	☐

AUG 2 2019

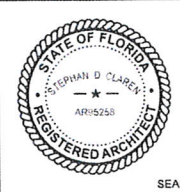

PROJECT #	19-013
DATE	6-3-2019
REV #	DATE
2	7-25-19
1	
1	
A-2.2

COPYRIGHT 2018

Claren Architecture + Design, Inc.

AA26002865
6400 CONGRESS AVE, SUITE 2150
BOCA RATON, FL 33487
561.961.4884

Discovery Plaza & Hotel

Village Parkway Dr. & SW Discovery Way
Port St. Lucie, FL 34987